

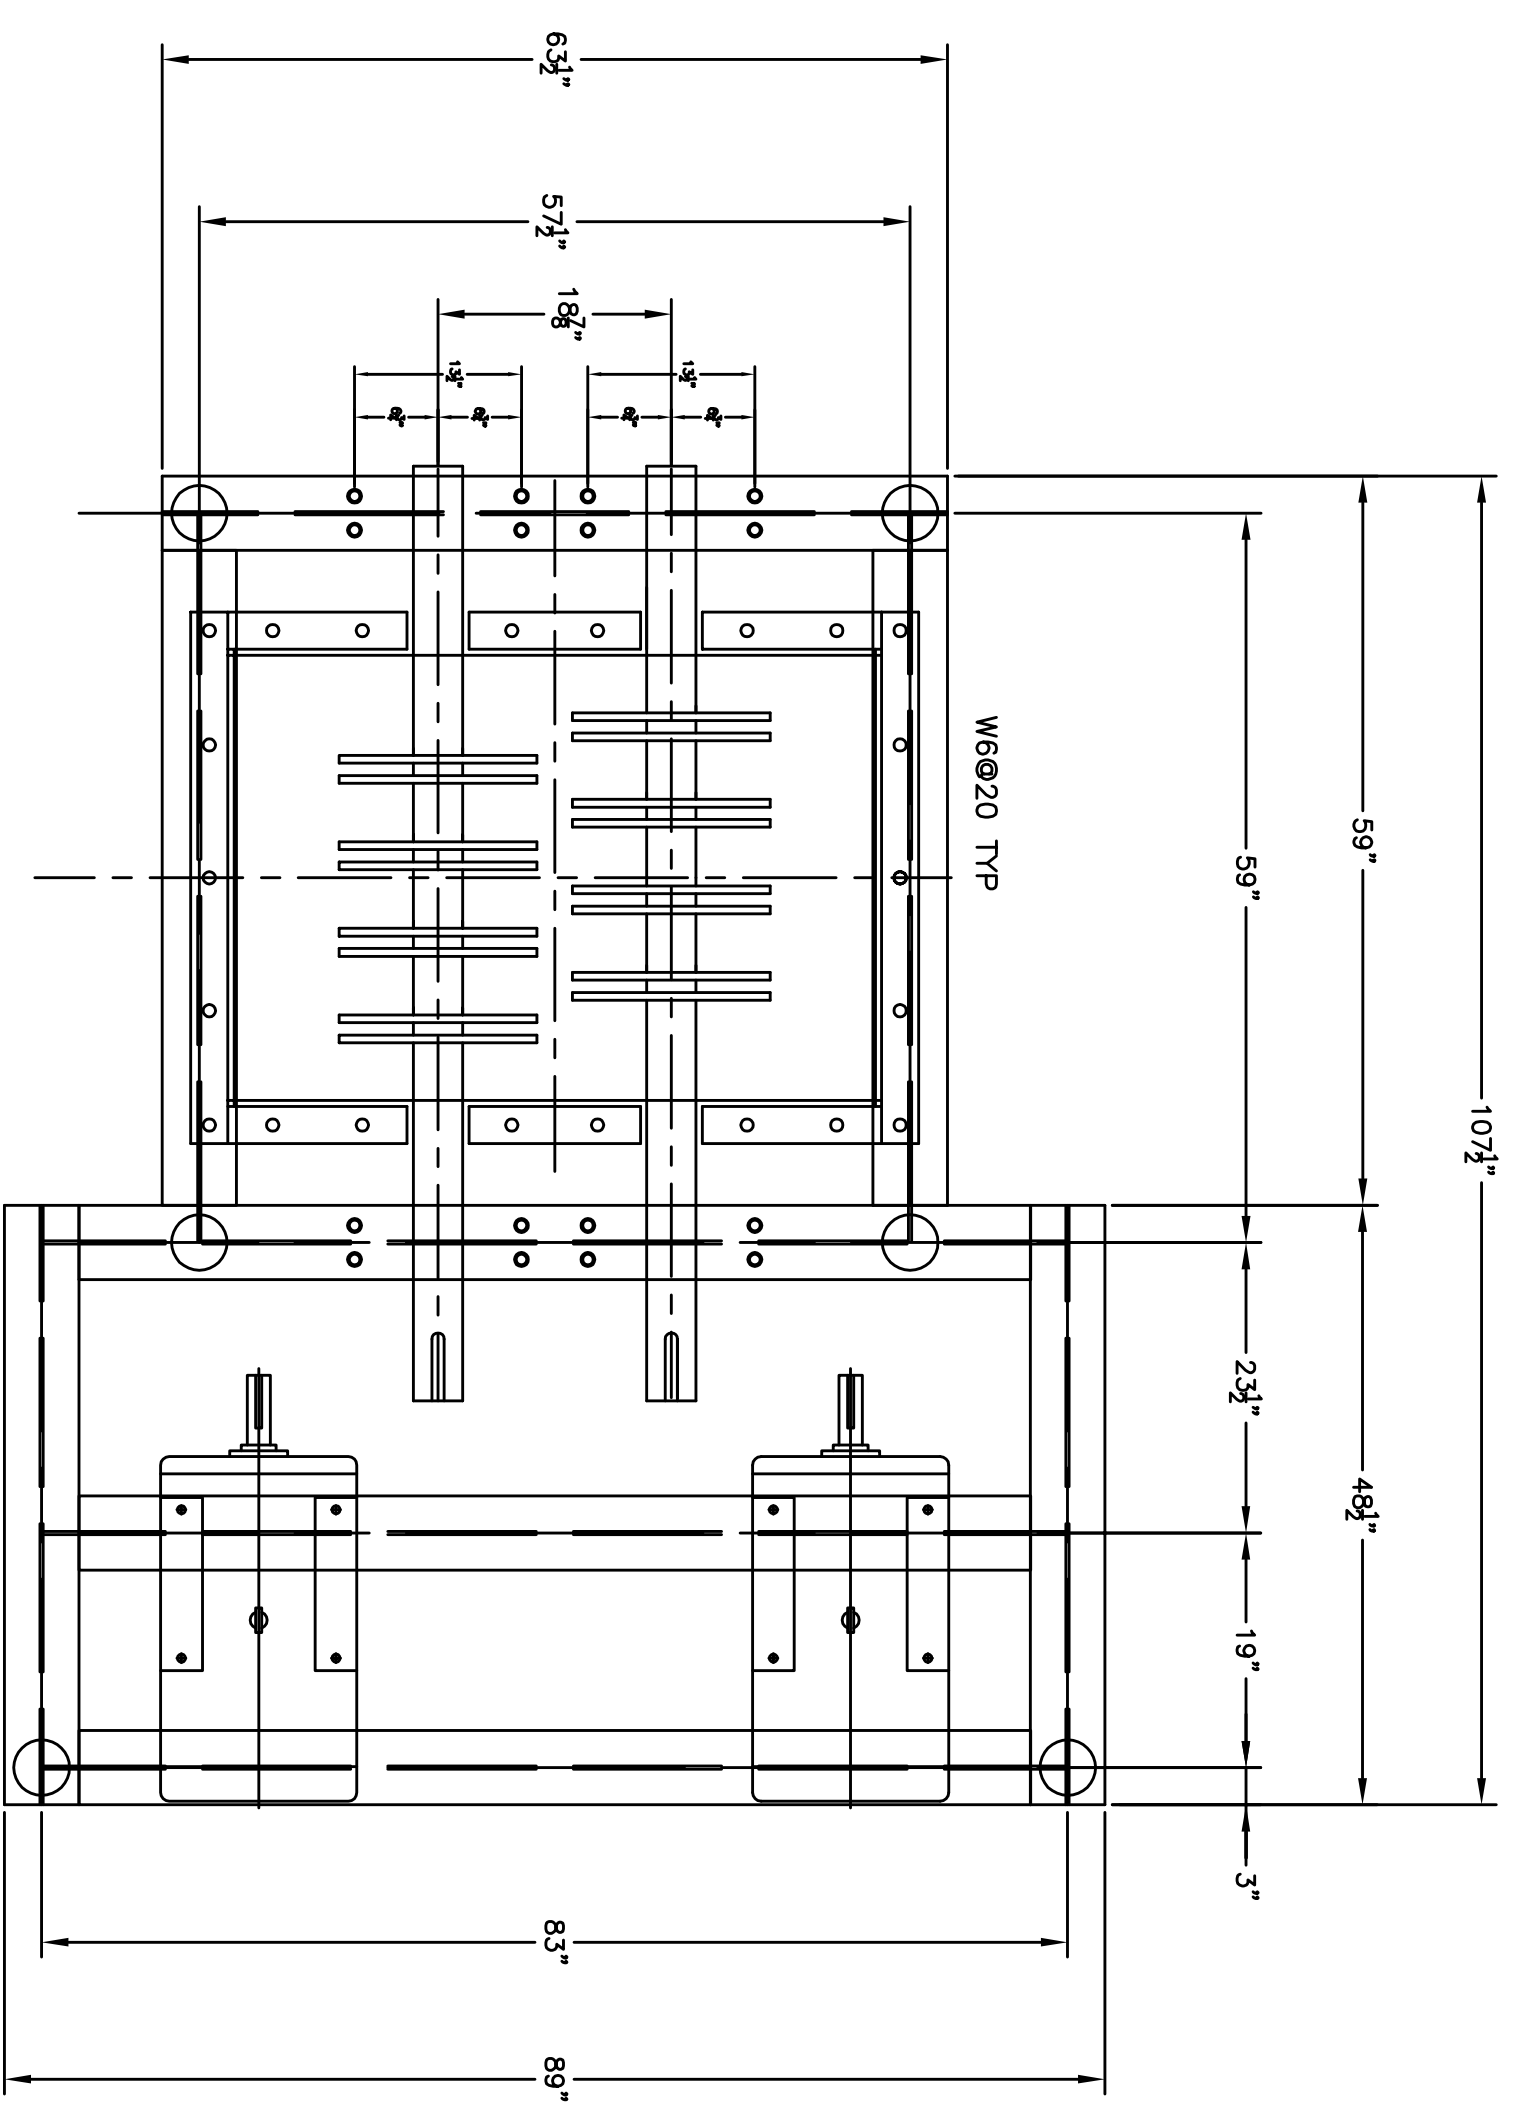


ALTERNATE #2

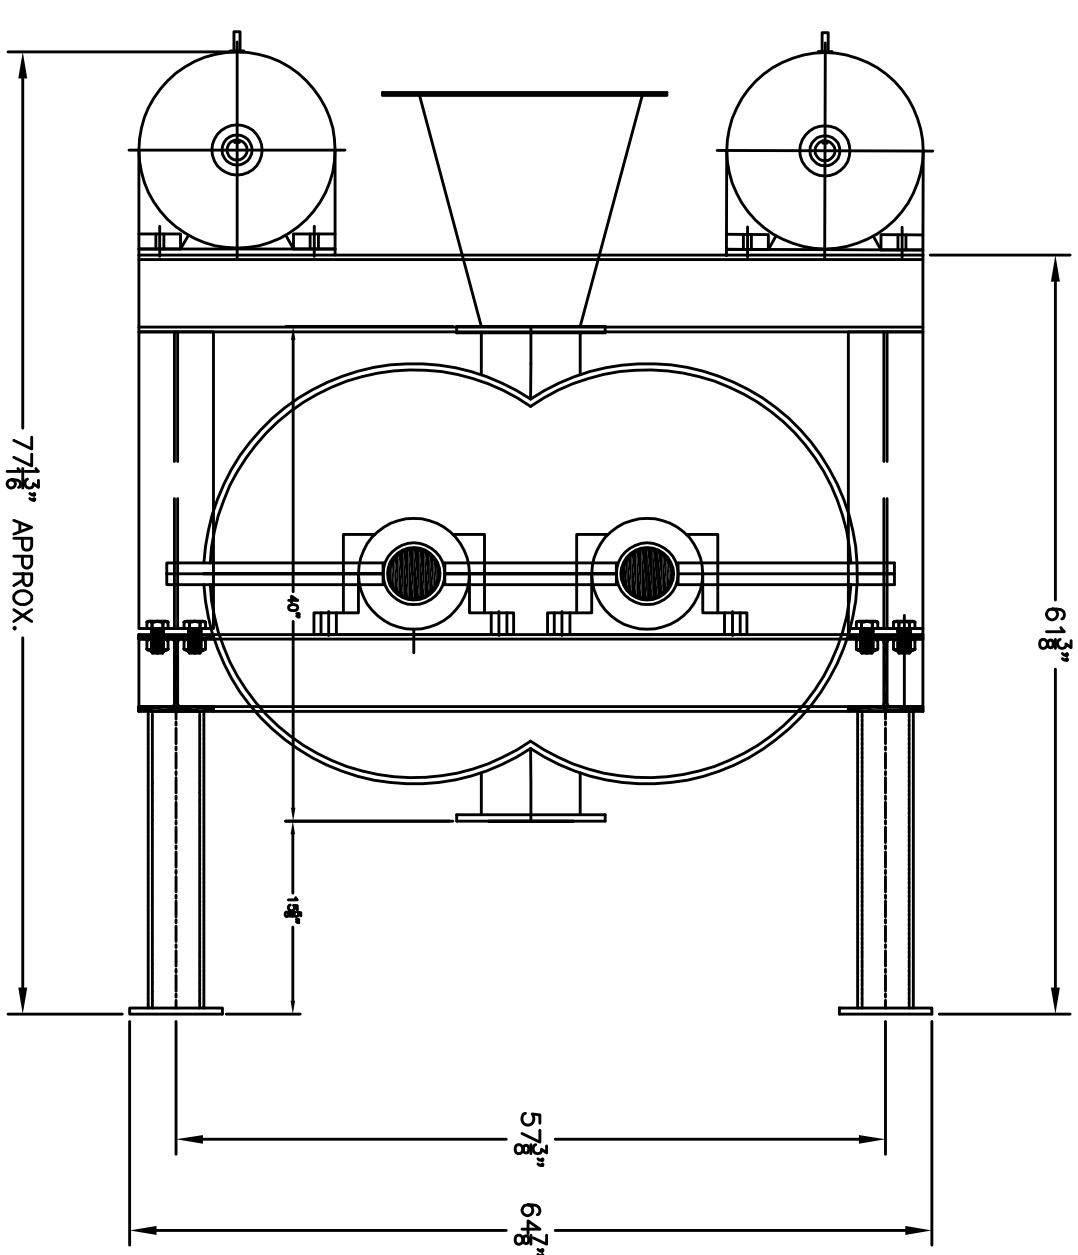

ALTERNATE #1

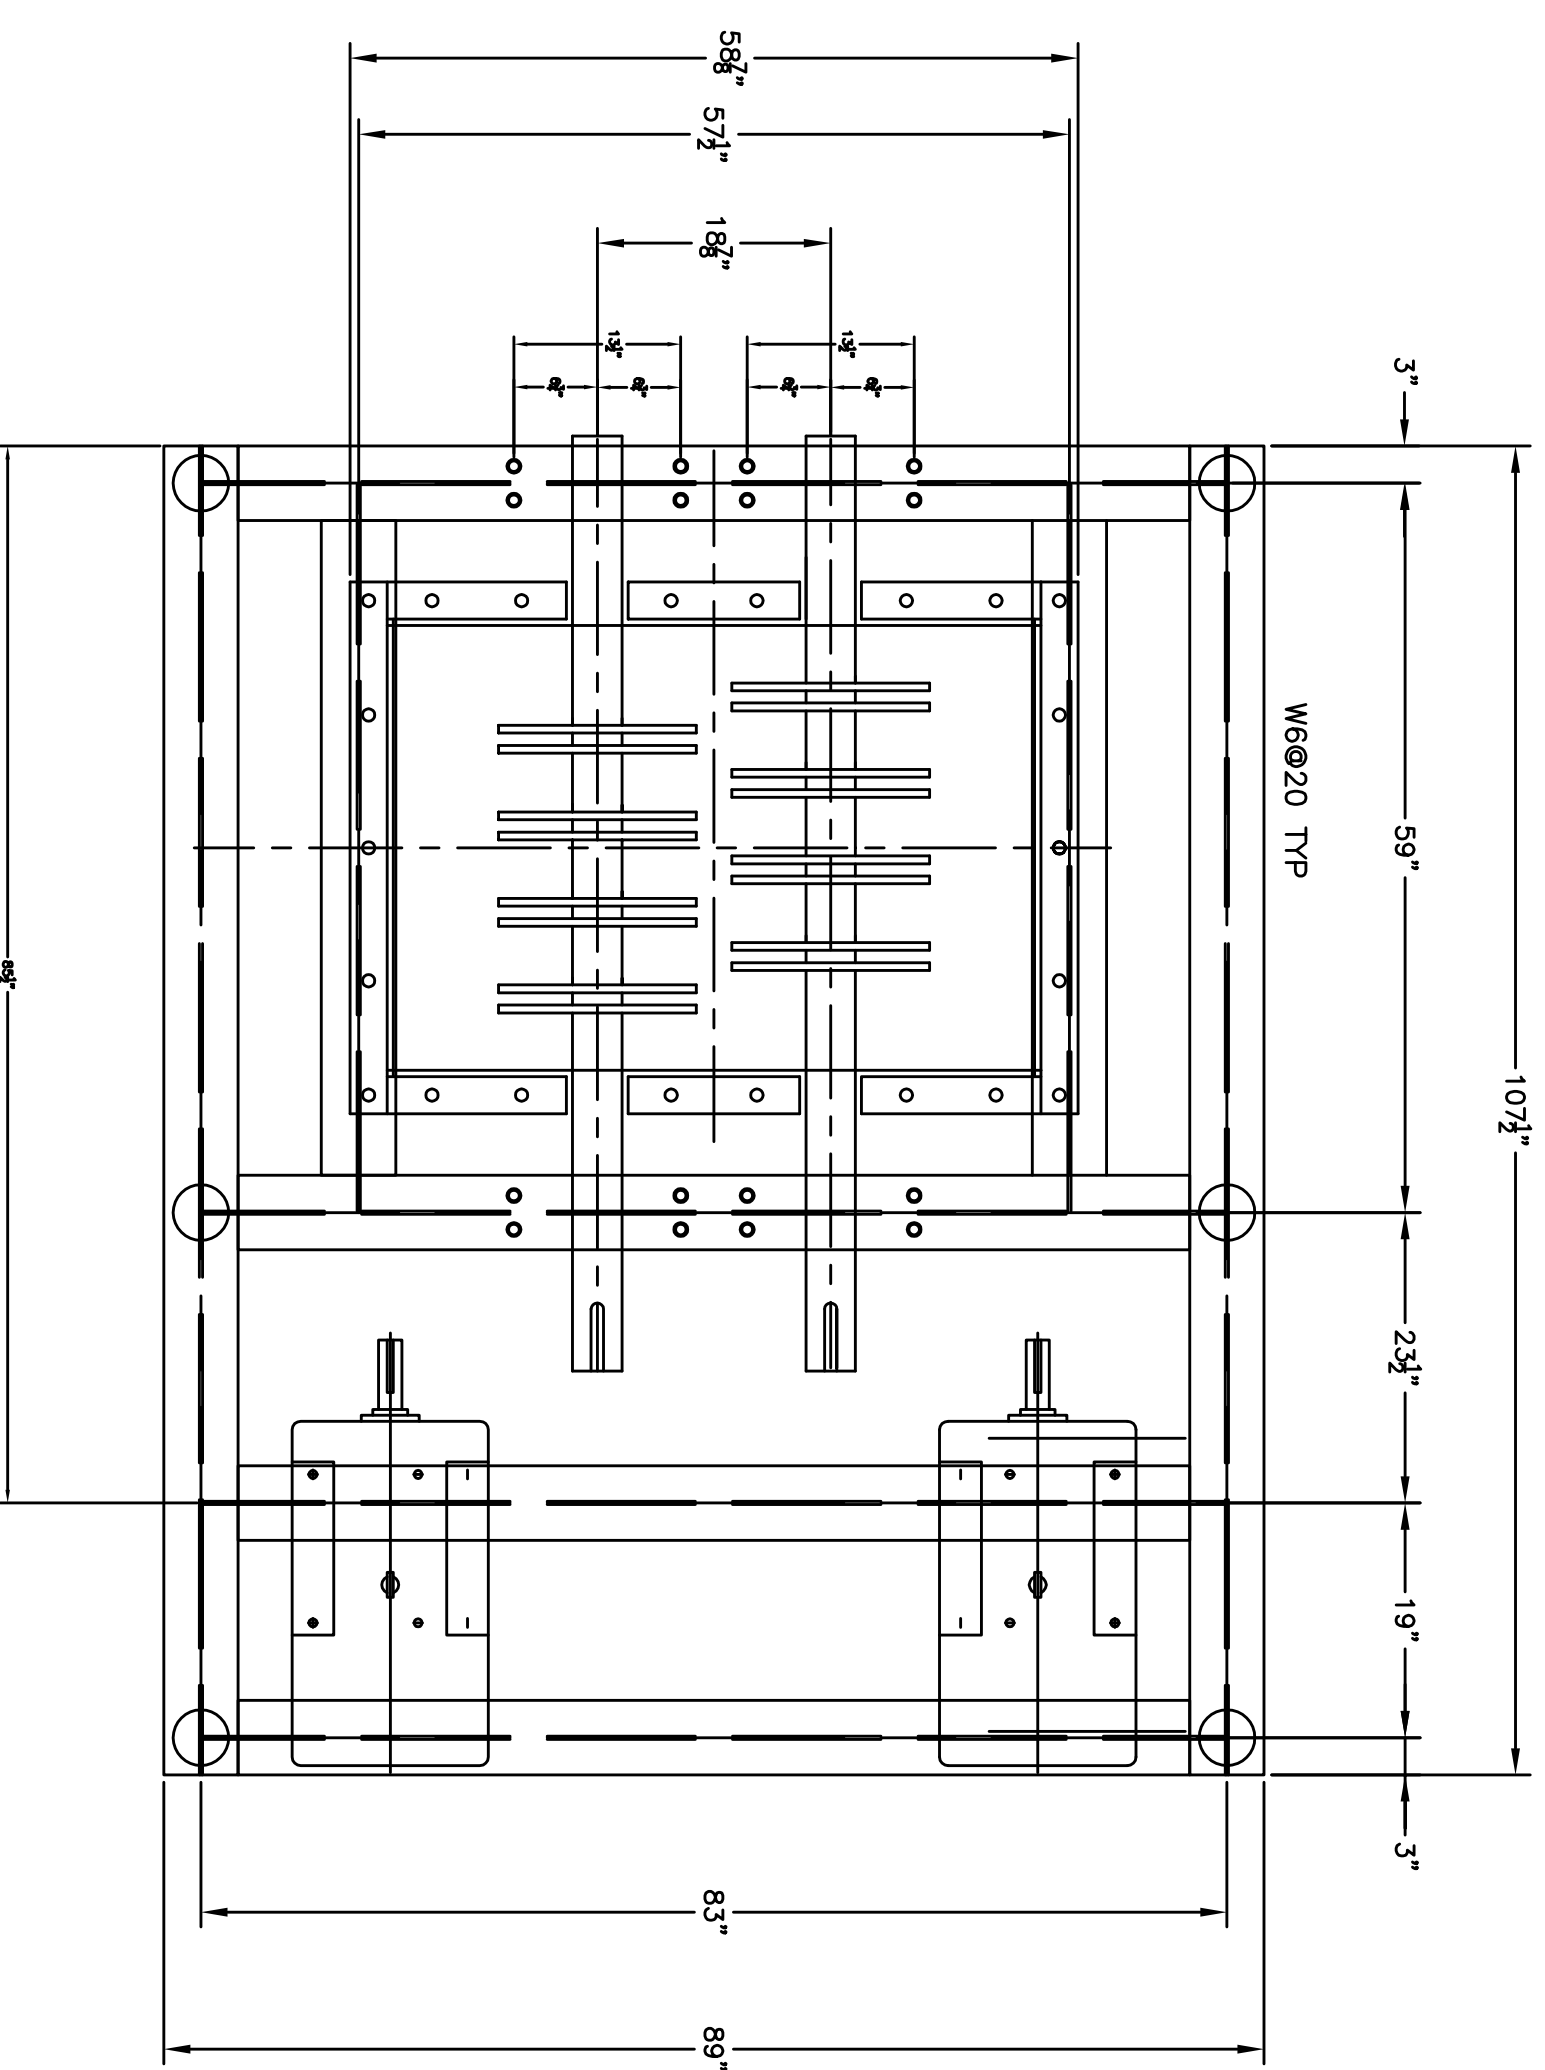

AS BUILT

